


As Built First Floor Plan




As Built Ground Floor Plan

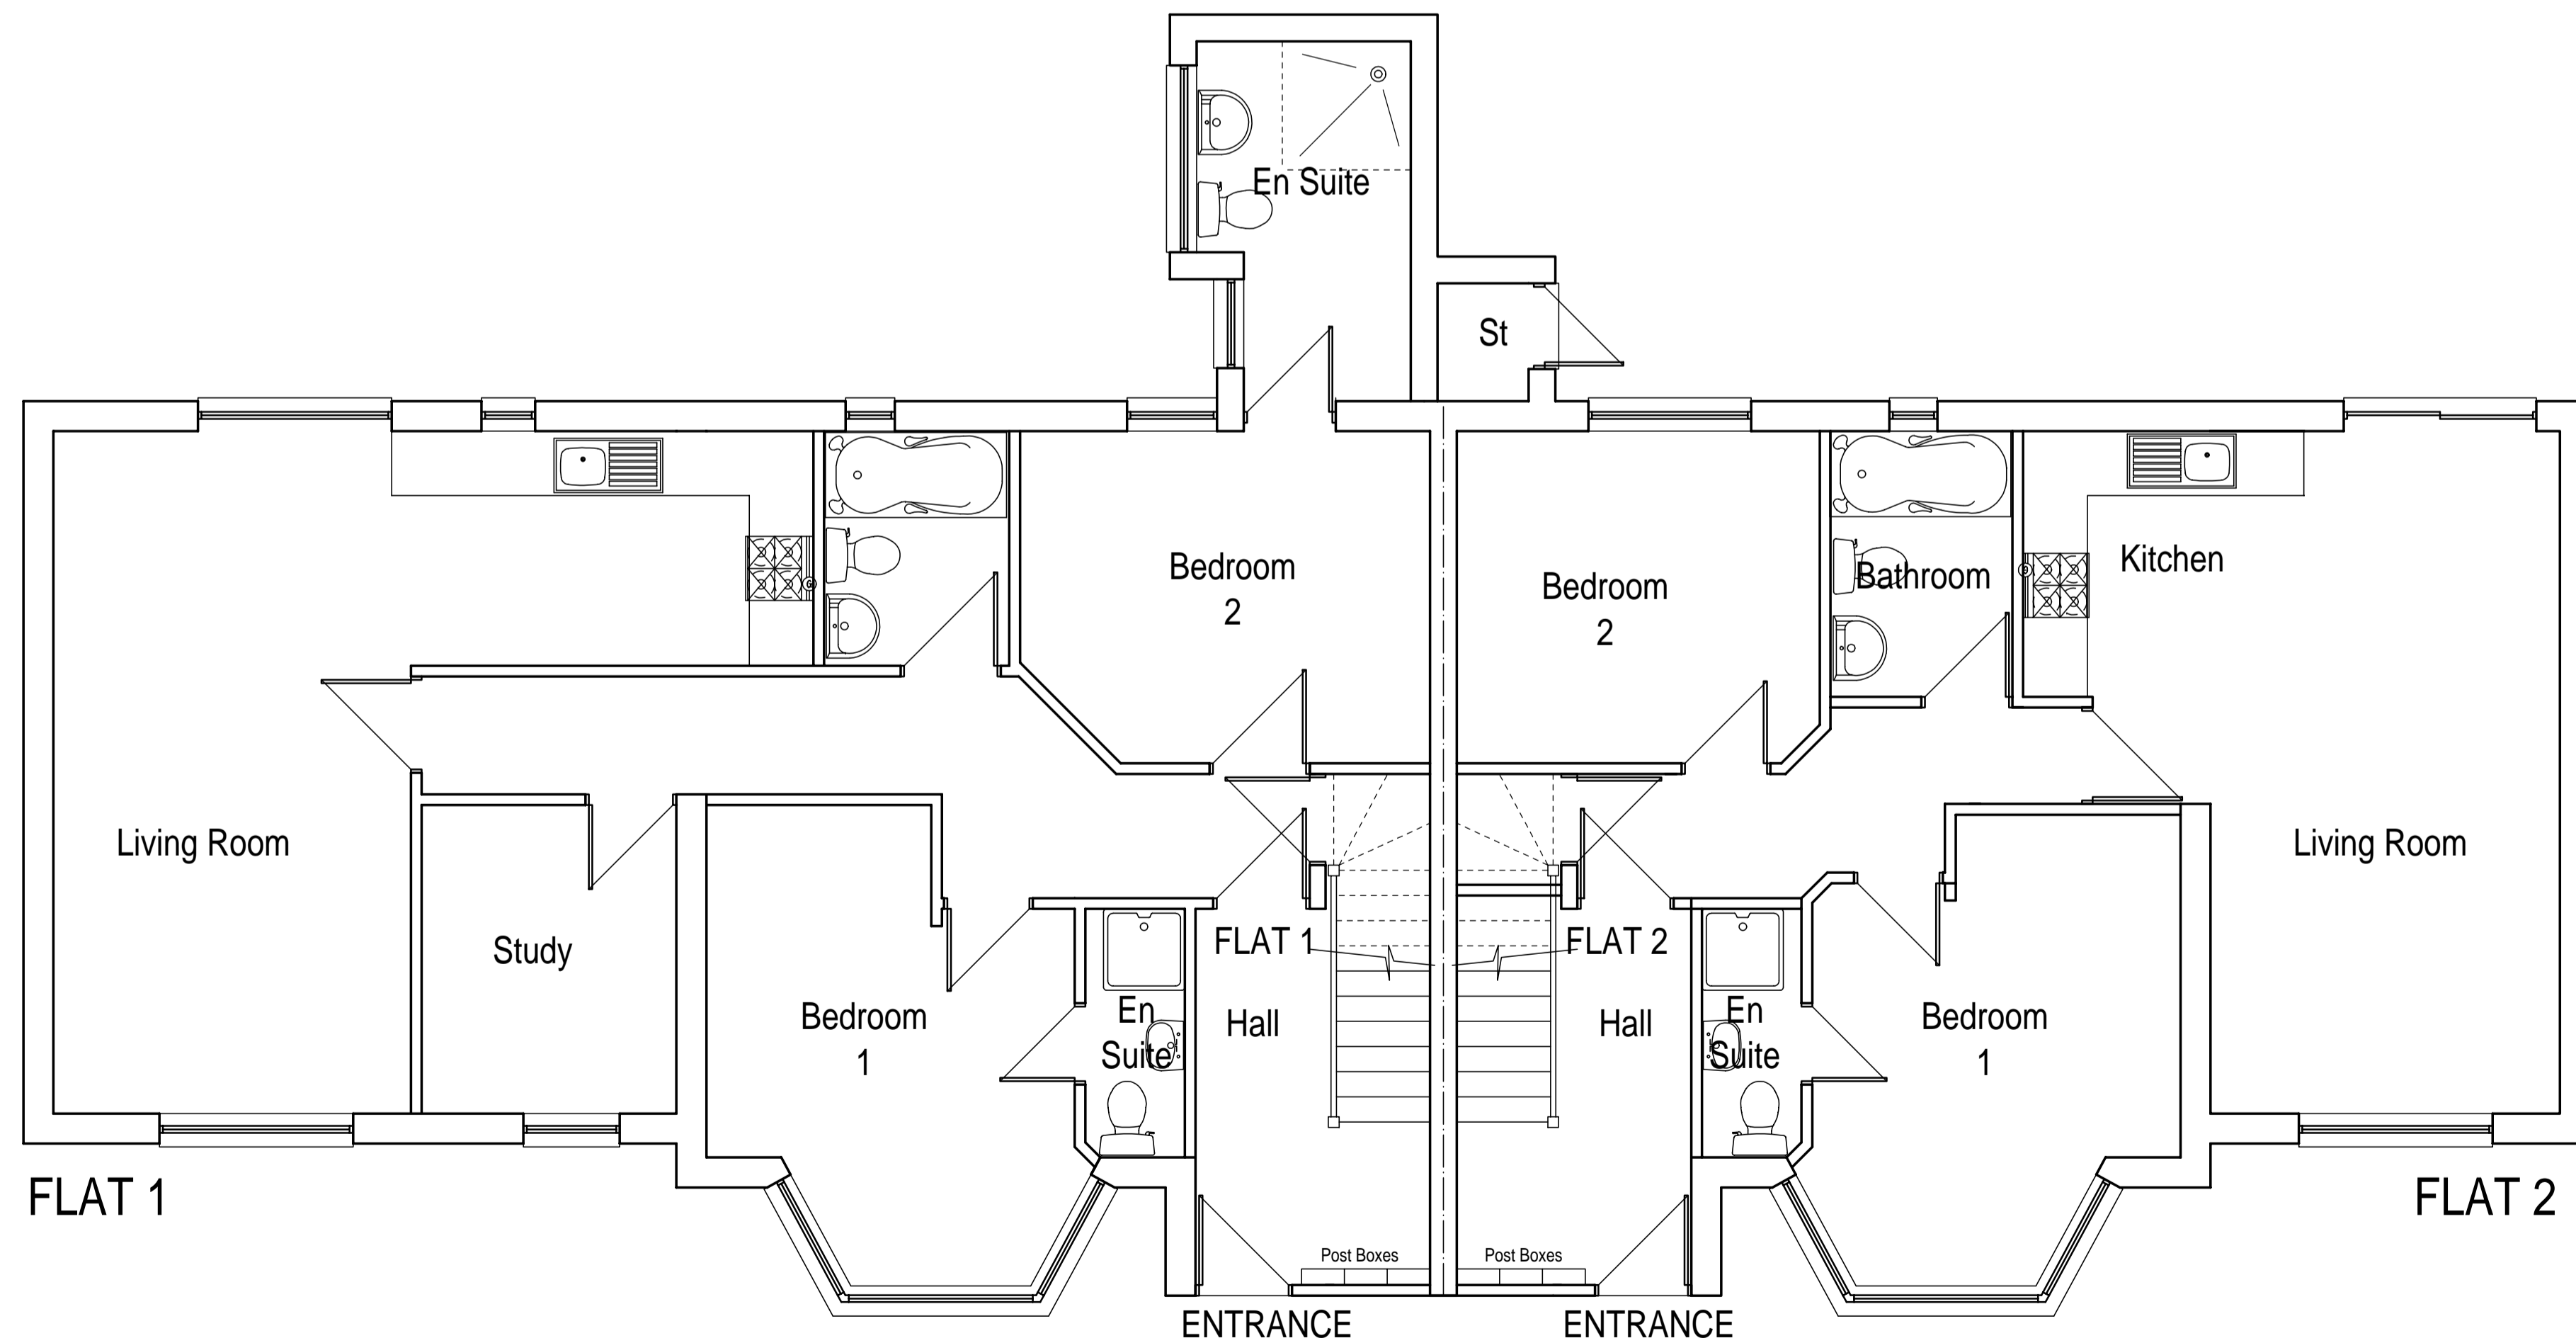

REV.	DATE	DESCRIPTION	BY
C	10.02.11	DRAWING NOTED AS 'AS BUILT'	GCD
B	26.10.10	SCALE LINE ADDED	GCD
A	27.09.10	LAYOUT REVISED FOLLOWING SITE VISIT	GCD

		49, The Crescent, Cradley Heath, West Midlands, B64 7JS Tel 0121 602 6233 Mob 07939 436557	
contract PROPOSED CHANGE USE 96-98, VANCOUVER ROAD EDWARE, HA8 5DF			
drawing AS BUILT GROUND & FIRST FLOOR			
client PBG			
scale 1:50	date SEPT 2010	drawn by GCD	
drawing no GD0982103	rev C	plot PLOT	cad lines CAD LINES

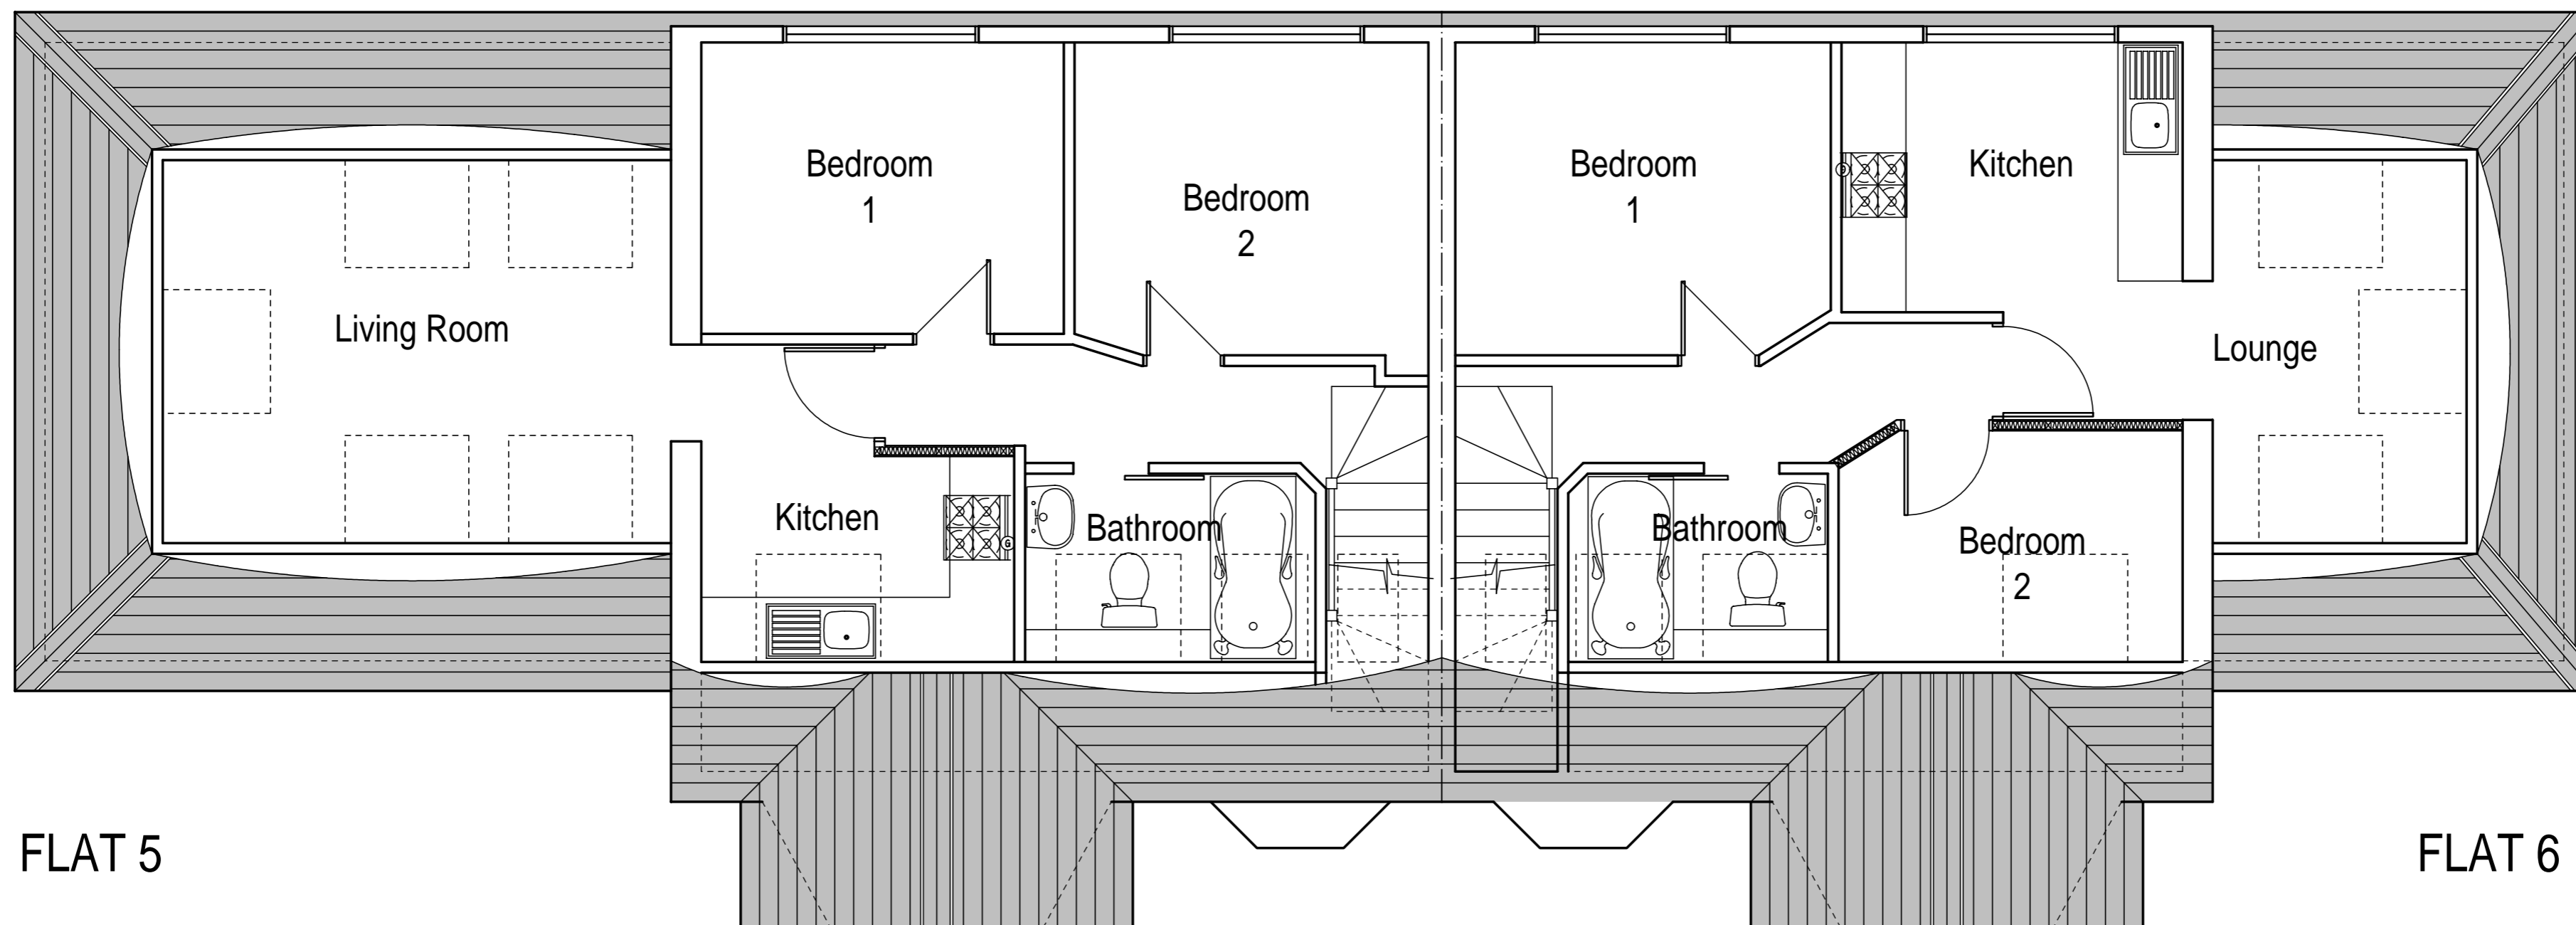

FLAT 5

FLAT 6

As Built Second Floor Plan

C	10.02.11	DRAWING NOTED AS 'AS BUILT'	GCD
B	26.10.10	SCALE LINE ADDED	GCD
A	27.09.10	LAYOUT REVISED FOLLOWING SITE VISIT	GCD

REV.	DATE	DESCRIPTION	BY
------	------	-------------	----

GD Designs
Architectural Services

49, The Crescent,
Cradley Heath,
West Midlands.
B64 7JS
Tel 0121 602 6233
Mob 07939 436557


contract
PROPOSED CHANGE USE
96-98, VANCOUVER ROAD
EDGWARE. HA8 5DF

drawing
AS BUILT SECOND FLOOR PLAN

client
PBS

scale 1:50 date SEPT 2010 drawn by GCD


drawing no GDO982104 C rev plot cad lines

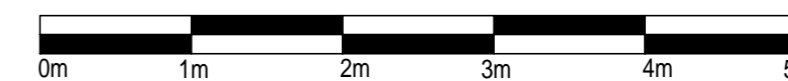




Pre Existing Front Elevation

HIP TO GABLE EXTENSION
VELUX ROOF LIGHTS

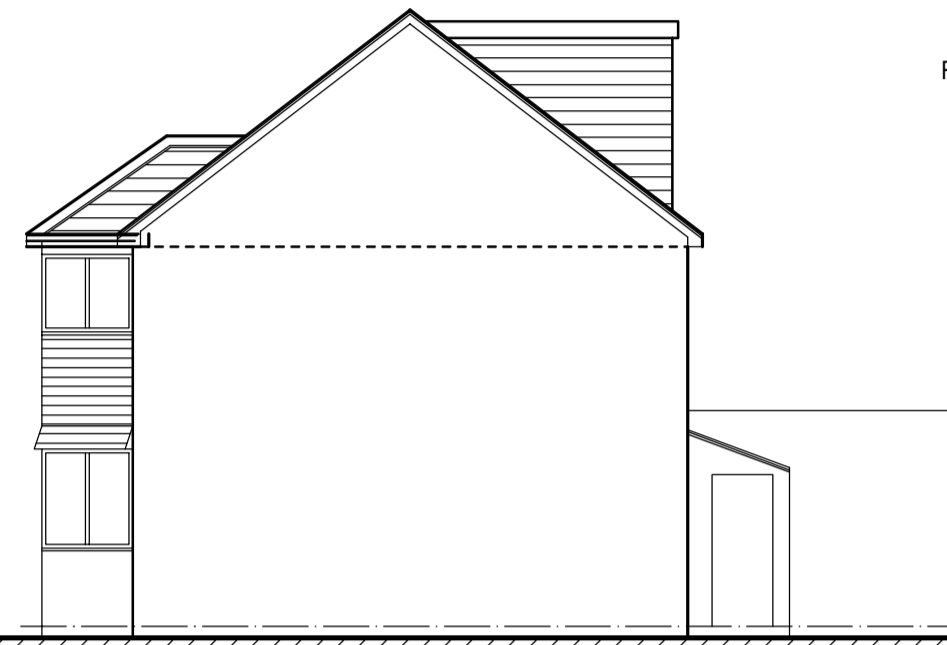


Pre Existing Side Elevation

REAR FACING DORMER WINDOWS

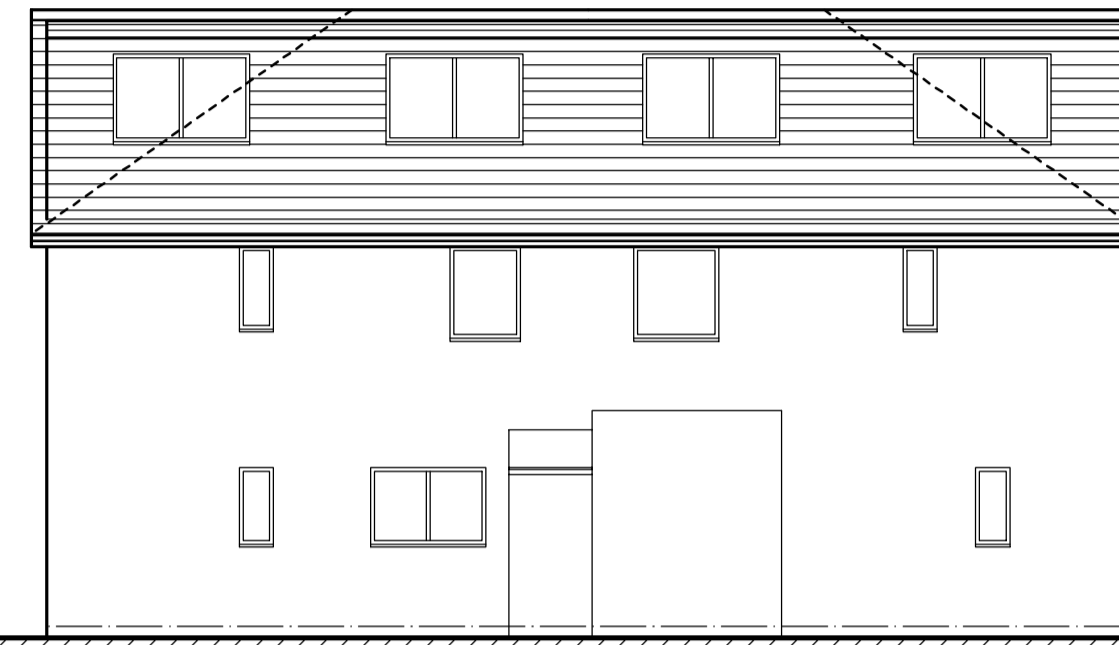

Pre Existing Rear Elevation

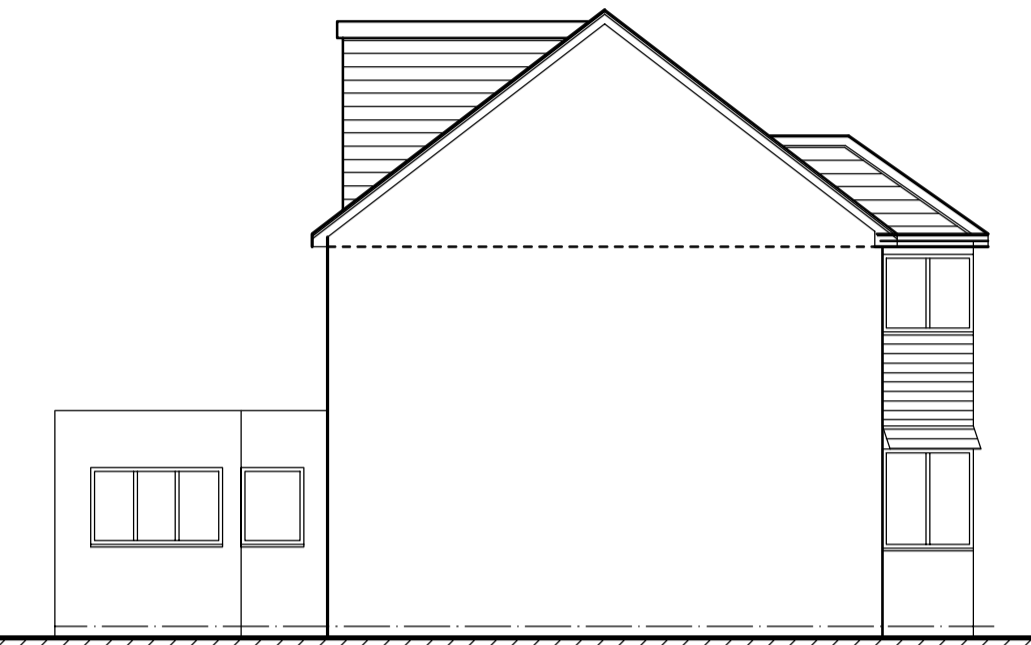


Pre Existing Side Elevation

PRE EXISTING ELEVATIONS SHOWING PERMITTED DEVELOPMENT CARRIED OUT TO EXISTING PAIR OF SEMI DETACHED HOUSES PRIOR TO SIDE EXTENSIONS




As Built Front Elevation

DOORS REMOVED & REPLACED
WITH NEW LETTER BOXES

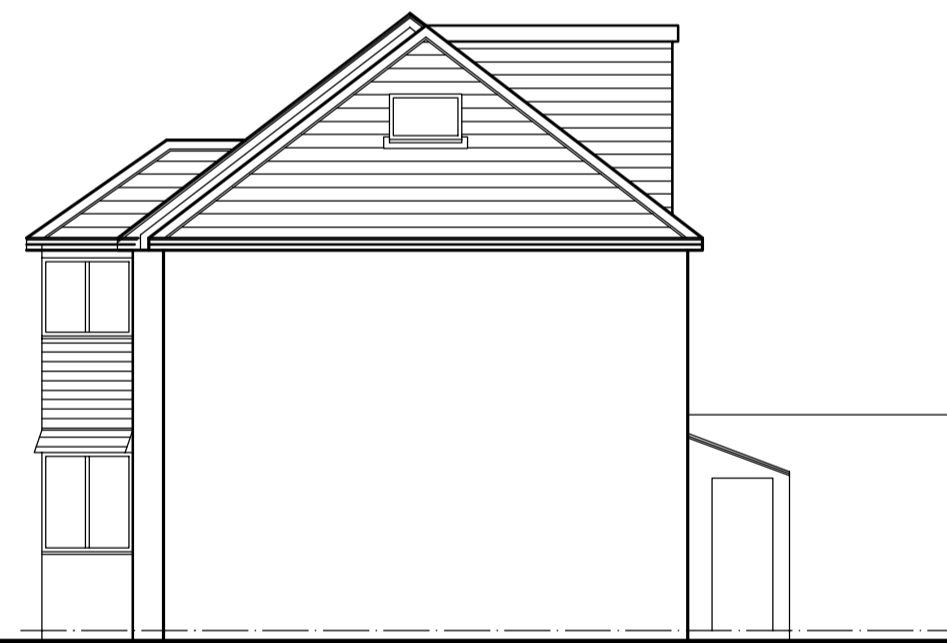


As Built Side Elevation

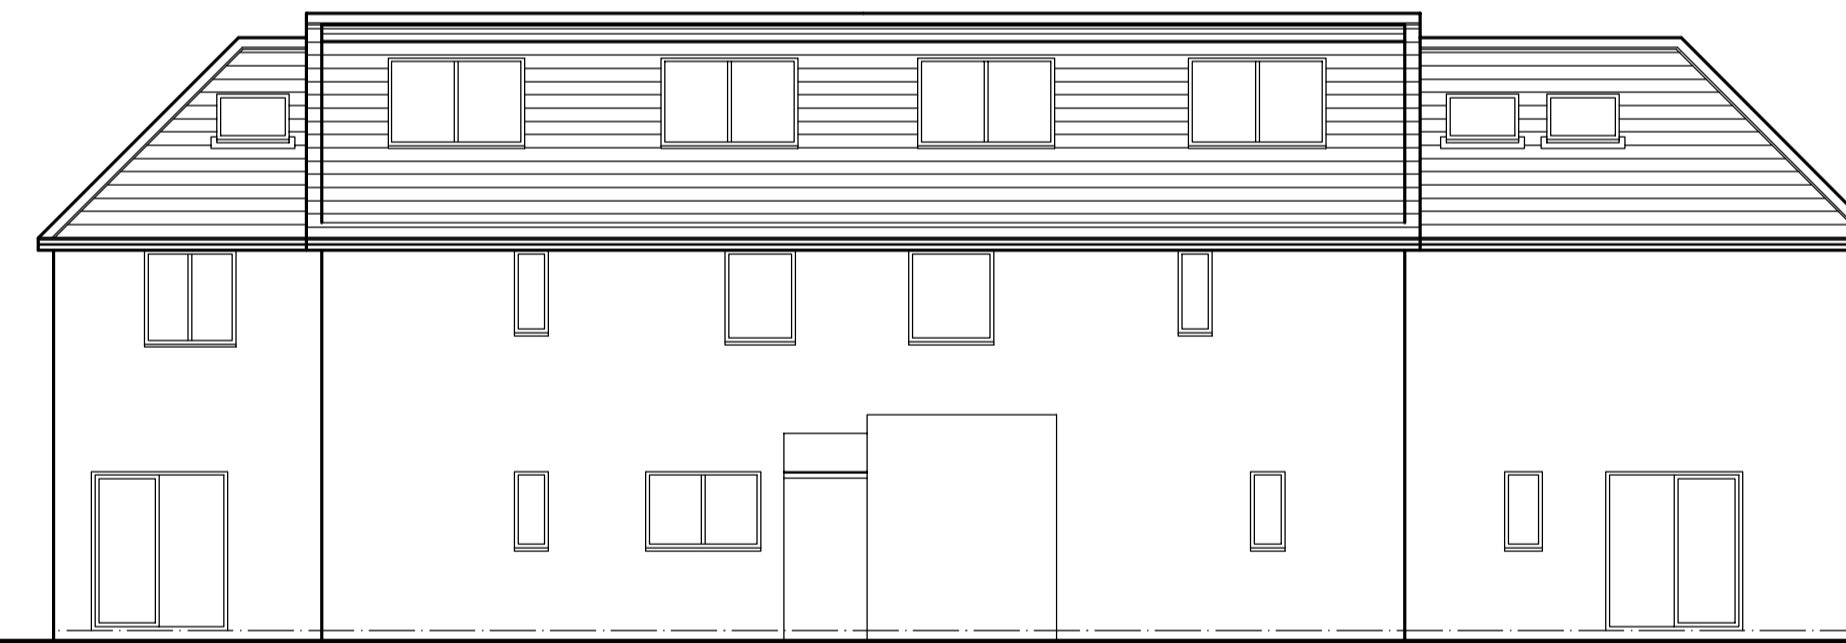

As Built Rear Elevation



As Built Side Elevation

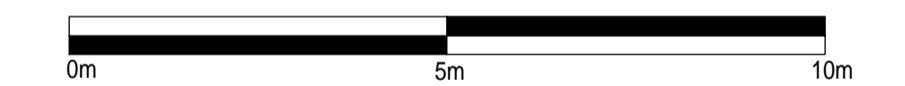

D	12.04.11	WINDOWS ADDED TO SIDE ELEVATION	GCD
C	10.02.11	ELEVATIONS RE NAMED	GCD
B	18.01.11	ADDITIONAL ELEVATIONS ADDED	GCD
A	28.10.10	SCALE LINE ADDED	GCD

REV.	DATE	DESCRIPTION	BY
------	------	-------------	----

GD Designs
Architectural Services

49, The Crescent,
Cradley Heath,
West Midlands.
B64 7JS
Tel 0121 602 6233
Mob 07939 436557

contract
PROPOSED CHANGE USE
96-98, VANCOUVER ROAD
EDGWARE, HA8 5DF

drawing
PRE EXISTING & AS BUILT ELEVATIONS

client
PBS

scale 1:100 date SEPT 2010 drawn by GCD

drawing no GDO982/08 D rev plot cad lines

T.J.M.F.
10/04/07
D.A.T.F.
10/04/07