


**Kellergeschoss \_ plan**

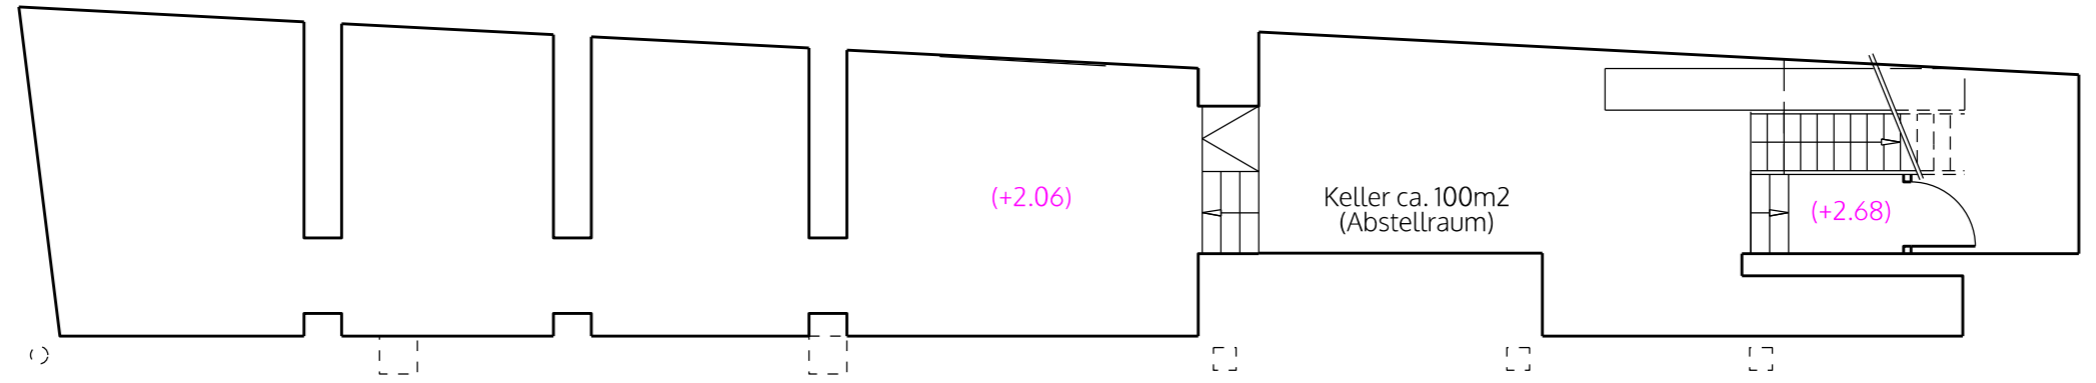

**spaceAgent**  
 Architects and Designers London-Heidelberg-Barcelona-Brussels  
 mail@spaceagent.com spaceagent.com  
 spaceAgent Architects Ltd is a RIBA Chartered Practice

project: GASTRONOMIE - UMBAU  
 Rathausstrasse 3  
 59494 Soest

client: BAWOAG  
 Noeckerstrasse 37F  
 44879 Bochum

title: Erd + Kellergeschoss  
 VORABZUG BESTANDSPLAN

BESTAND	
1:100 @A3	
1:50 @A1	
28.2.2023	
I.lezzi	

RAT\_E02f9